


RAKOMATIC MILLING MACHINE

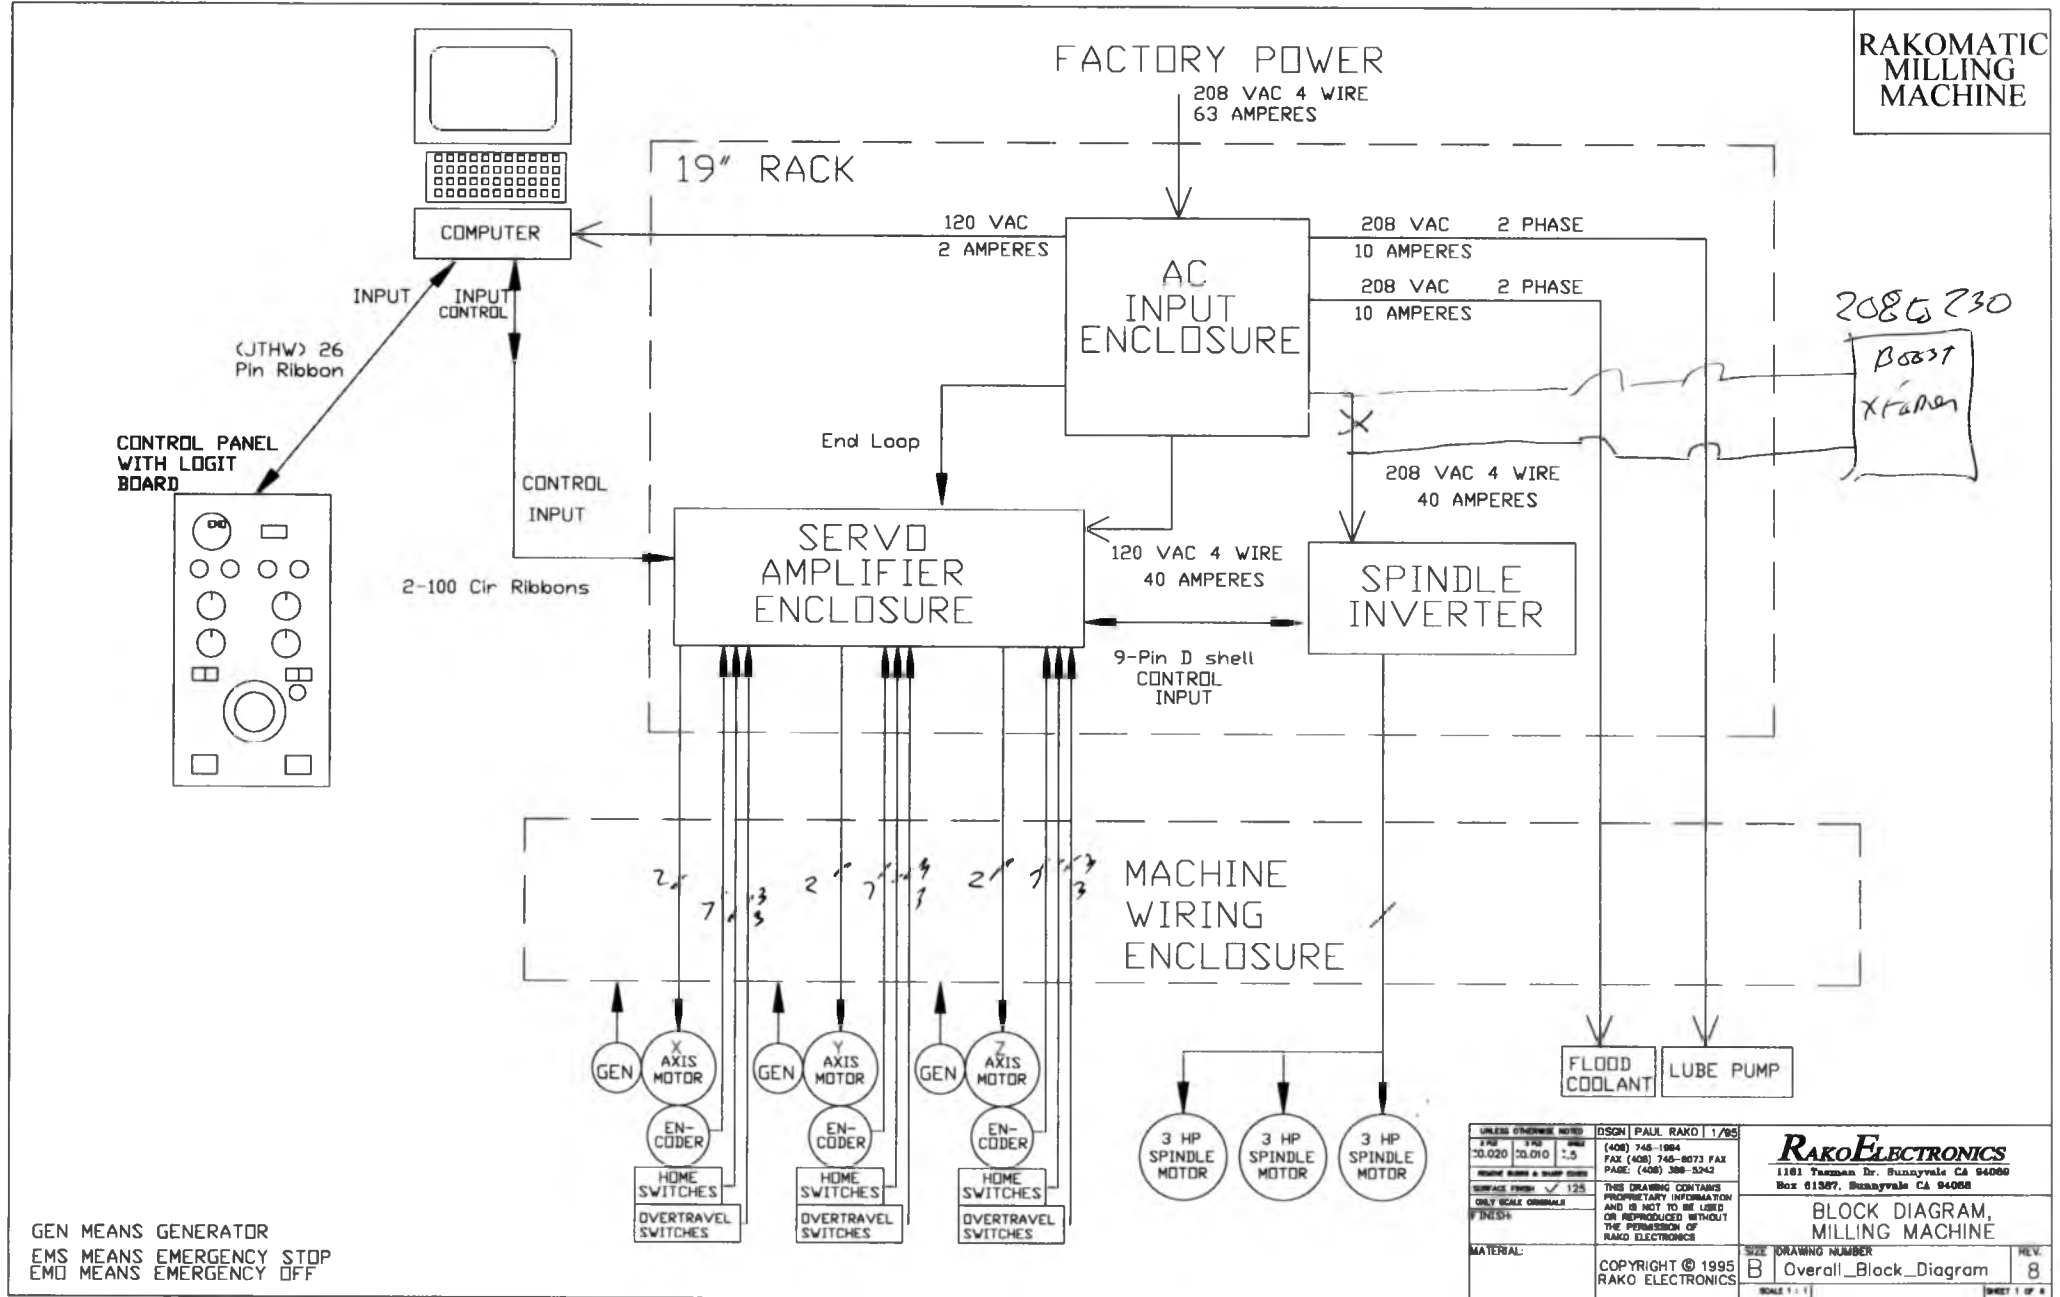

GEN MEANS GENERATOR
 EMS MEANS EMERGENCY STOP
 EMO MEANS EMERGENCY OFF

| | | | | | |
|-----------------------------------|--------|------|--|-----------|------|
| UNLESS OTHERWISE NOTED | | | DSGN | PAUL RAKO | 1/95 |
| STD | STD | SIZE | (408) 748-1884 | | |
| 00.020 | 00.010 | 1:5 | FAX (408) 748-8073 FAX | | |
| SURFACE FINISH & SHARP CORNERS | | | PAGE (408) 388-5242 | | |
| ONLY SCALE ORIGINALS | | | THIS DRAWING CONTAINS PROPRIETARY INFORMATION AND IS NOT TO BE USED OR REPRODUCED WITHOUT THE PERMISSION OF RAKO ELECTRONICS | | |
| FINISH: | | | BLOCK DIAGRAM, MILLING MACHINE | | |
| MATERIAL: | | | SIZE DRAWING NUMBER | | |
| COPYRIGHT © 1995 RAKO ELECTRONICS | | | B Overall_Black_Diagram | | |
| SCALE 1:1 | | | REV. 8 | | |