


Operator Control Panel




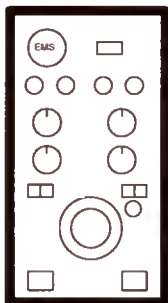


Remote Handwheel

FACTORY POWER

208 VAC 4 WIRE
63 AMPERES

2-100 Cir Ribbons,
26 Cir Ribbon
15 Cir Ribbon

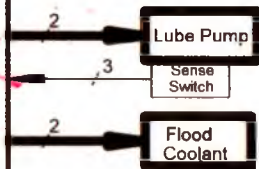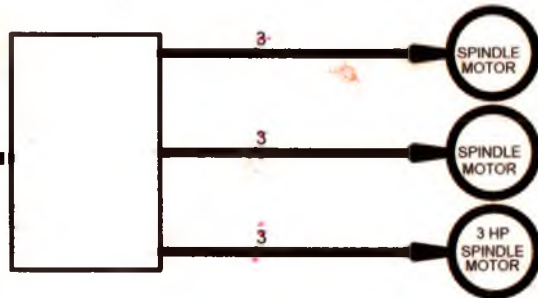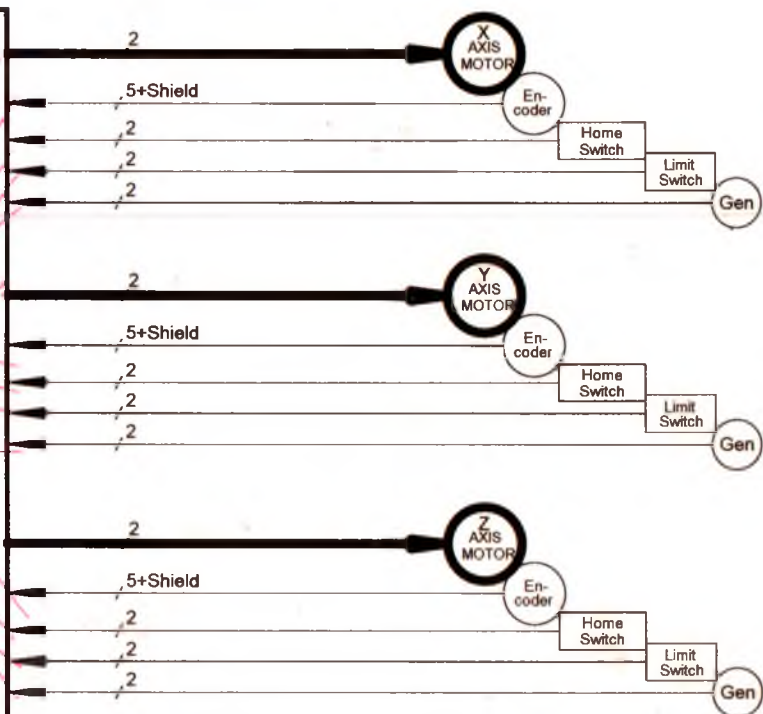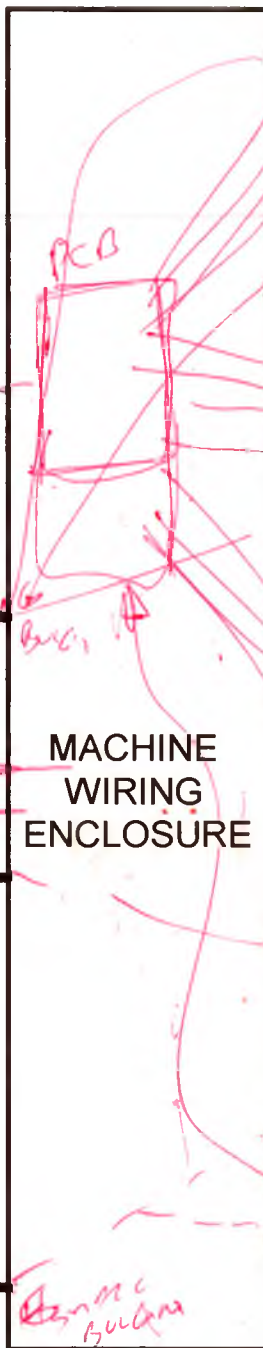

GEN MEANS GENERATOR
EMS MEANS EMERGENCY STOP
EMO MEANS EMERGENCY OFF

UNLESS OTHERWISE NOTED DIMENSIONS ARE IN INCHES TOLERANCES FINISH MATERIAL	DSGN PAUL RAKO 1 1995 1408 745-1984 FAX 1408 745-6073 FAX PAGE 1408 388-5242 THIS DRAWING CONTAINS PROPRIETARY INFORMATION AND IS NOT TO BE USED OR REPRODUCED IN ANY MANNER WITHOUT THE PERMISSION OF RAKO ELECTRONICS	RAKO ELECTRONICS 1181 Taaman Dr. Sunnyvale CA 94089 Box 81387, Sunnyvale CA 94088 Cable DIAGRAM, MILLING MACHINE
COPYRIGHT © 1995 RAKO ELECTRONIC	SIZE B DRAWING NUMBER Overall_Cable_Diagram	REV 9