

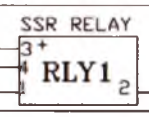
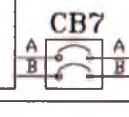
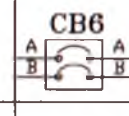
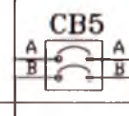
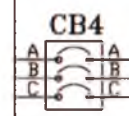
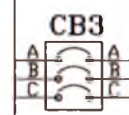
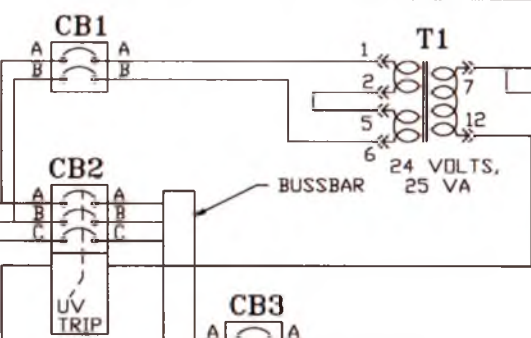


208 VAC  
3 PHASE

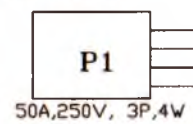

EMO/CONTROL  
PART OF  
J6

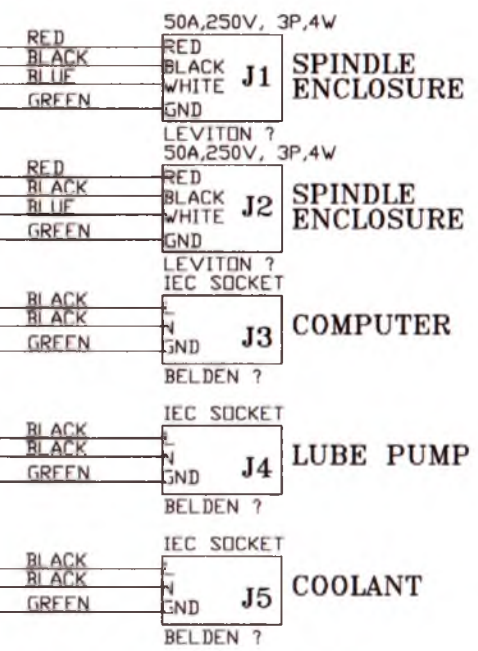

PART OF  
J6  
EMO CONTROL

NOTES:  
"UV" MEANS UNDER VOLTAGE

<small>DESIGN: PAUL RAKO B.2/95 (408) 745-1994 FAX (408) 745-8073 FAX PHONE (408) 388-5242</small>			
<small>THIS DRAWING CONTAINS PROPRIETARY INFORMATION AND IS NOT TO BE USED OR REPRODUCED WITHOUT THE PERMISSION OF RAKO ENGINEERING</small>		<small>1181 Teaman Dr. Sunnyvale CA 94089 Box 81387, Sunnyvale CA 94088</small>	
SCHEMATIC, AC ENCLOSURE			
<small>COPYRIGHT © 1995 RAKO ENGINEERING</small>	<small>SIZE DRAWING NUMBER B AC_SCH_A.DWG</small>	<small>REV. 3</small>	<small>SCALE N/A</small>