


COMPUTER

FROM AC ENCLOSURE

120 VAC 3 WIRE
2 AMPERES

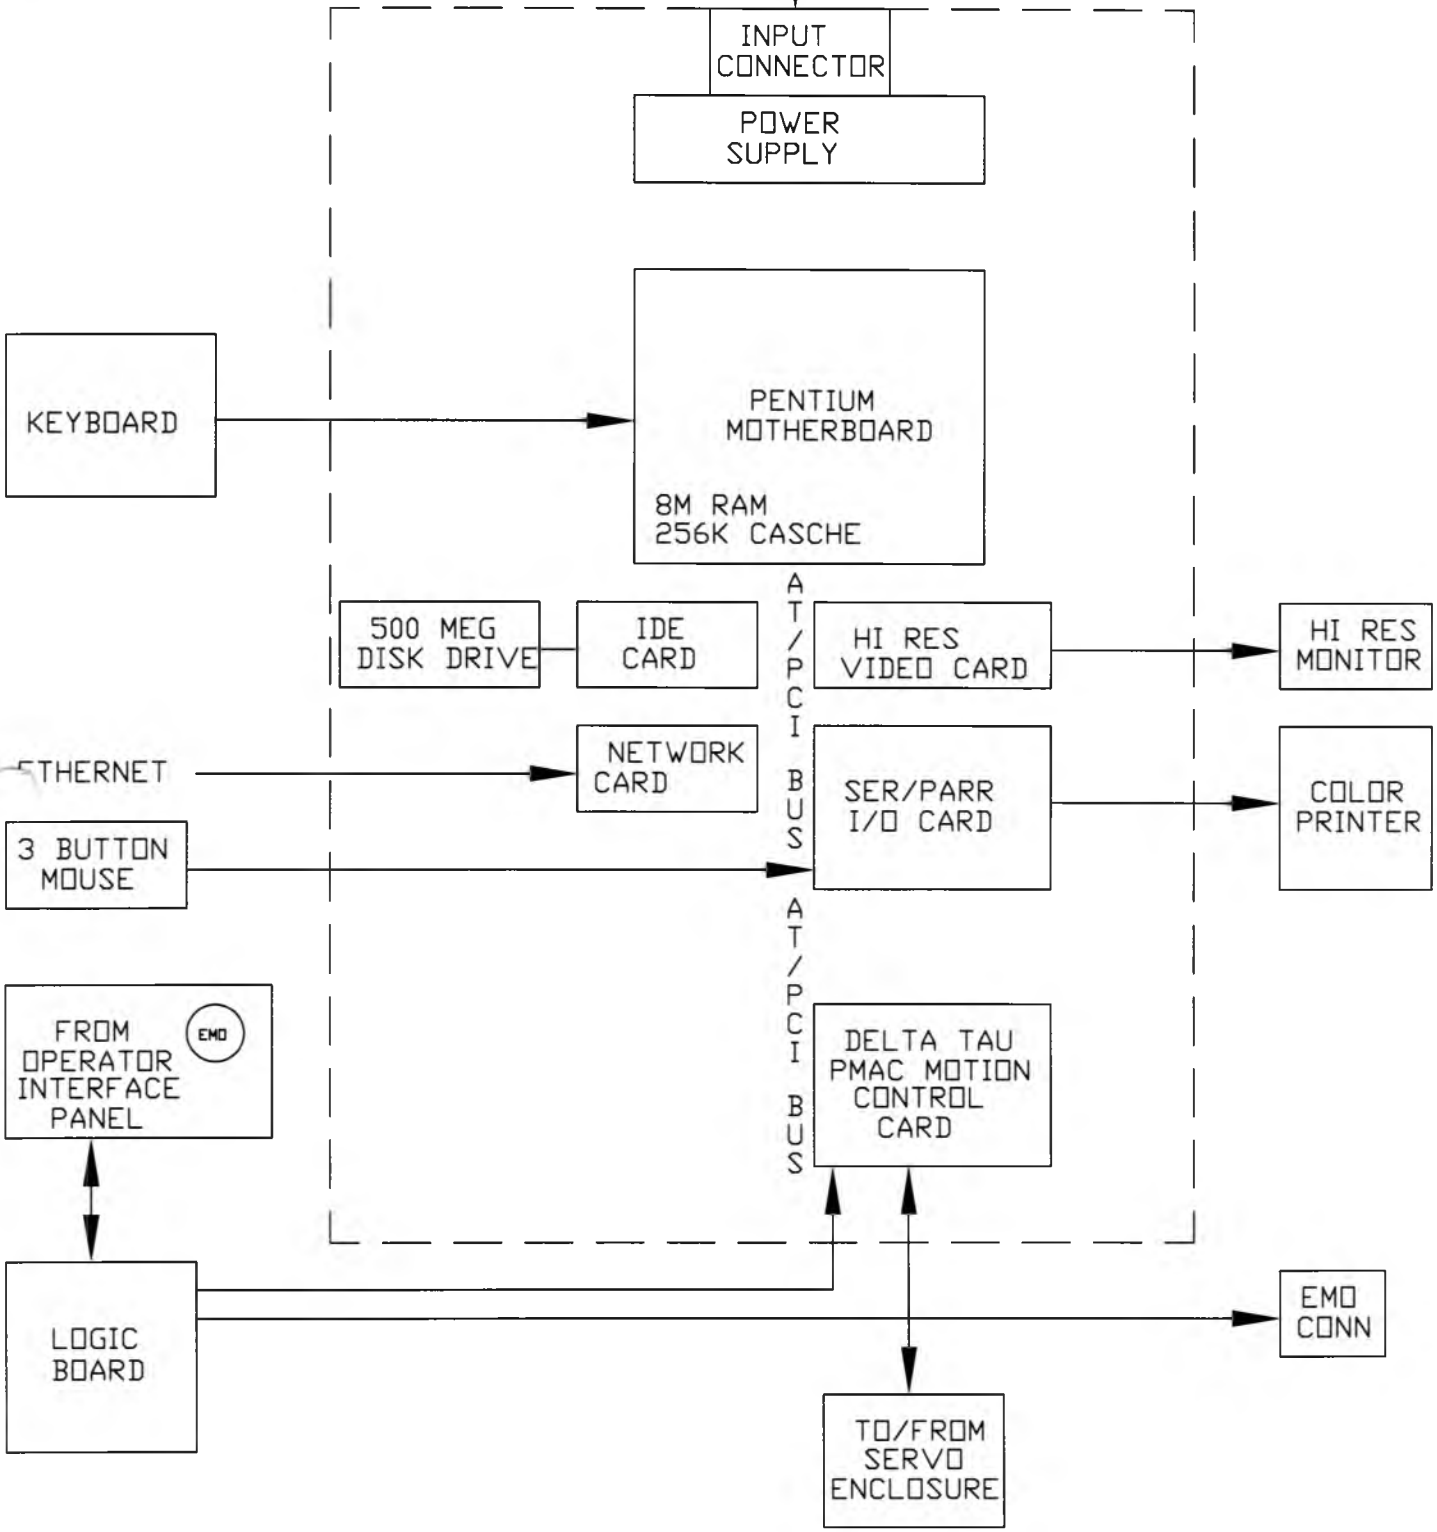

LIM 1,2,3 MEANS LIMIT SWITCHS 1,2 AND 3
EMO MEANS EMERGENCY OFF
UV MEANS UNDERVOLTAGE TRIP

DSGN | PAUL RAKO | 1/95
(408) 745-1984
FAX (408) 745-8073 FAX
PAGE: (408) 388-5242
THIS DRAWING CONTAINS
PROPRIETARY INFORMATION
AND IS NOT TO BE USED
OR REPRODUCED WITHOUT
THE PERMISSION OF
RAKO ELECTRONICS
COPYRIGHT © 1995
RAKO ELECTRONICS

RAKO ELECTRONICS
1161 Tasman Dr. Sunnyvale CA 94089
Box 61387, Sunnyvale CA 94088

BLOCK DIAGRAM,
MILLING MACHINE

SIZE	DRAWING NUMBER	REV.
A	BLOCK	4

SCALE 1 : 1 FILE: BLOCK.DWG

SHEET 2 OF 5