


ALL INFORMATION CONTAINED HEREIN IS UNCLASSIFIED EXCEPT WHERE SHOWN OTHERWISE

TRAINING IS THE SOLE PROPERTY OF RAKO ENGINEERING, INC. NO PART OF THESE MATERIALS MAY BE REPRODUCED OR TRANSMITTED IN ANY FORM OR BY ANY MEANS WITHOUT THE WRITTEN PERMISSION OF RAKO ENGINEERING, INC.

Sokka

314-3100

Jim Armstrong

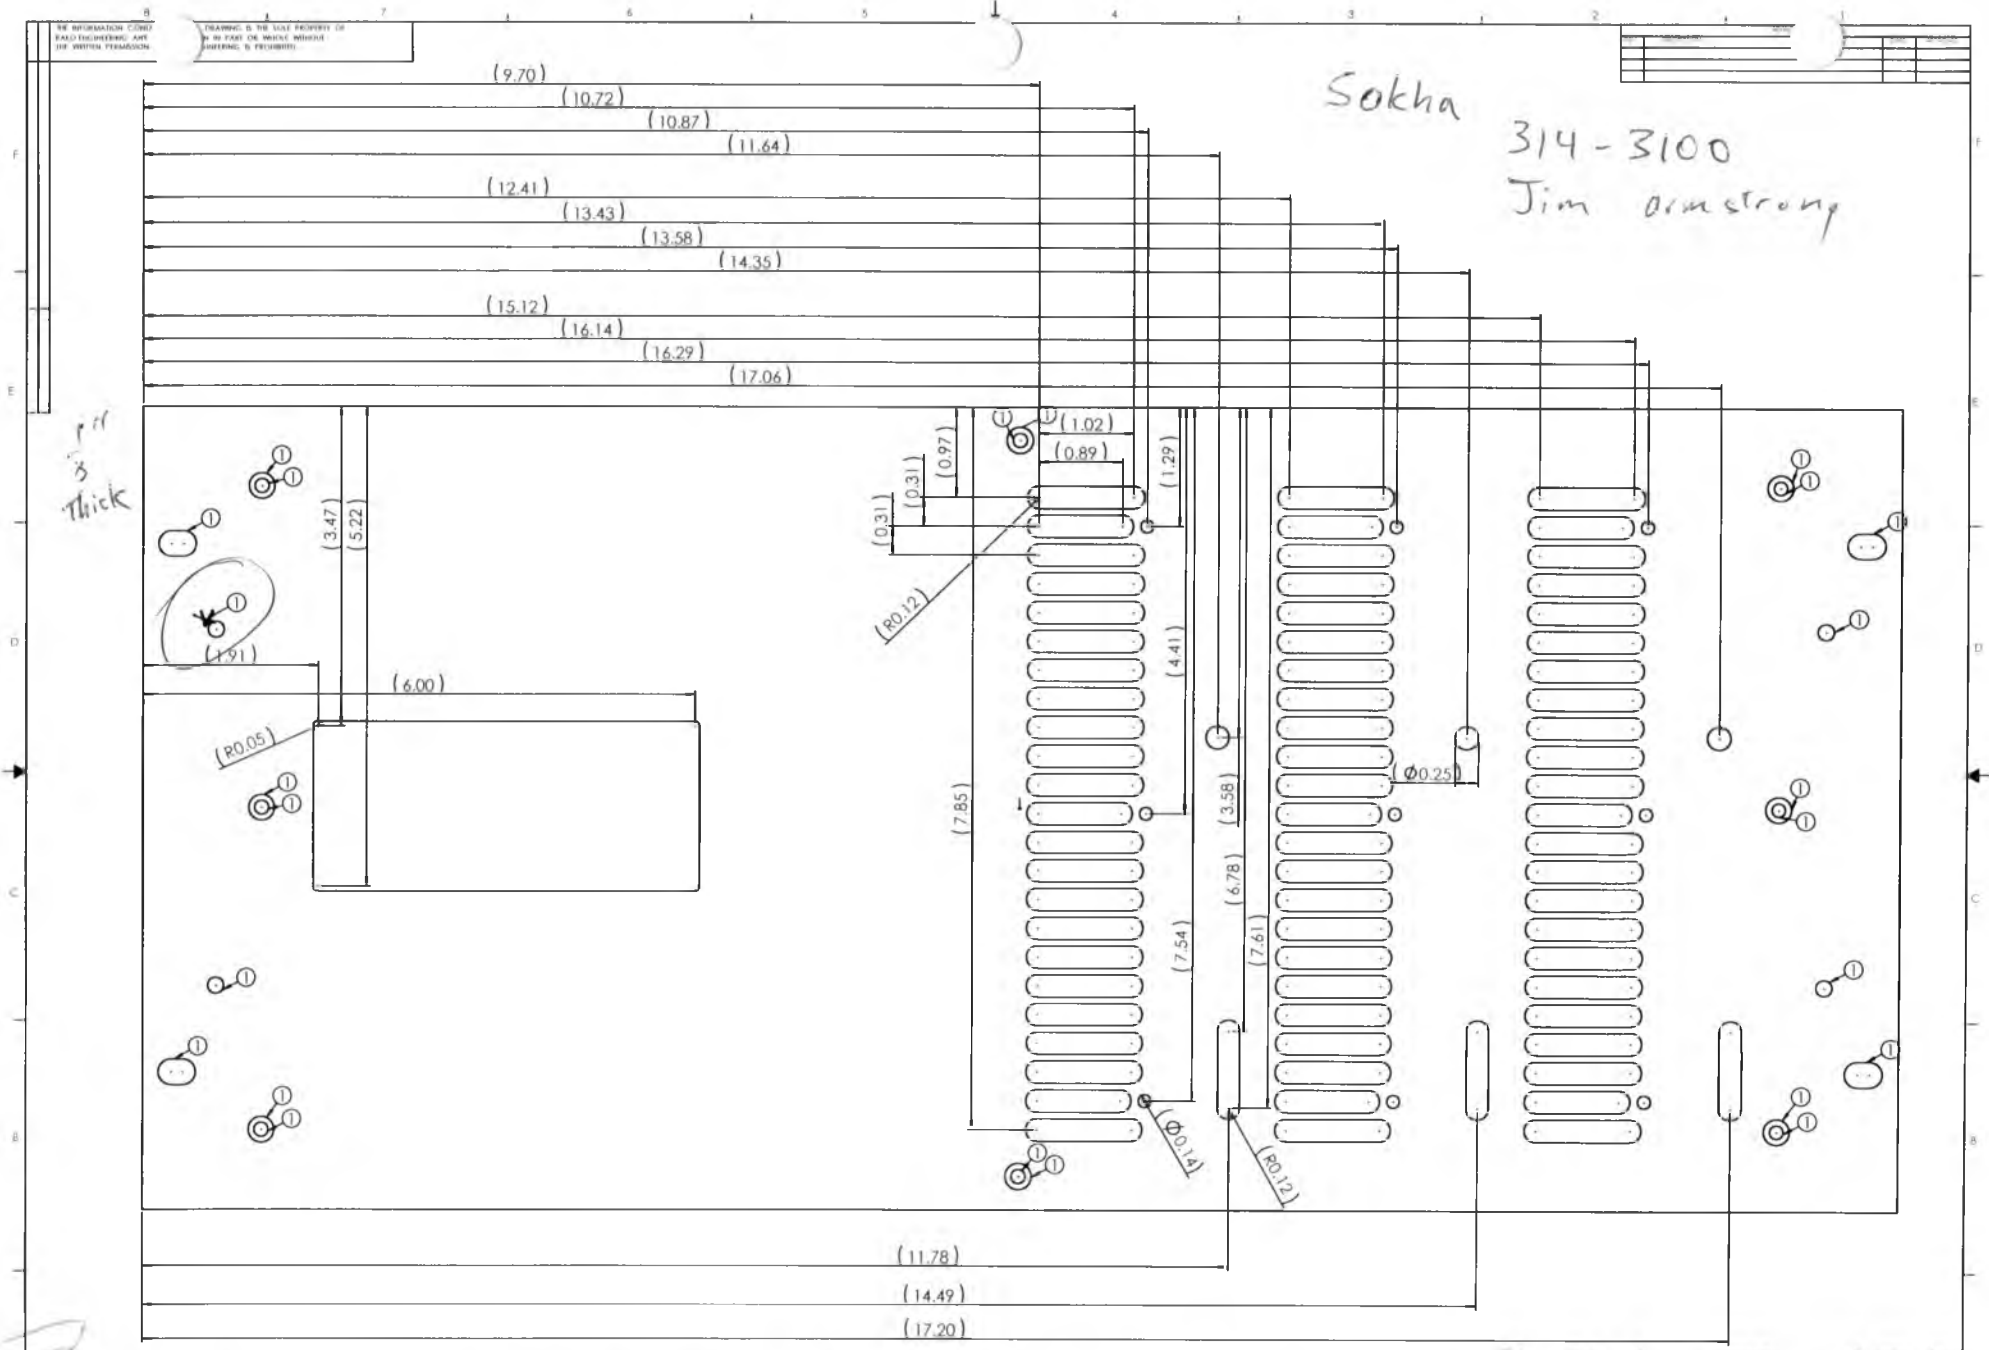

671 aldo Unit 22 Santa Clara
 off off dela cruz. Han

RAKO ENGINEERING	
FRONT PANEL	
DATE	7/11/01
DESIGNER	
CHECKED BY	
APPROVED BY	
SCALE	
SHEET NO.	
TOTAL SHEETS	