


FROM AC ENCLOSURE

208 VAC 4 WIRE
40 AMPERES

SERVO AMPLIFIER ENCLOSURE

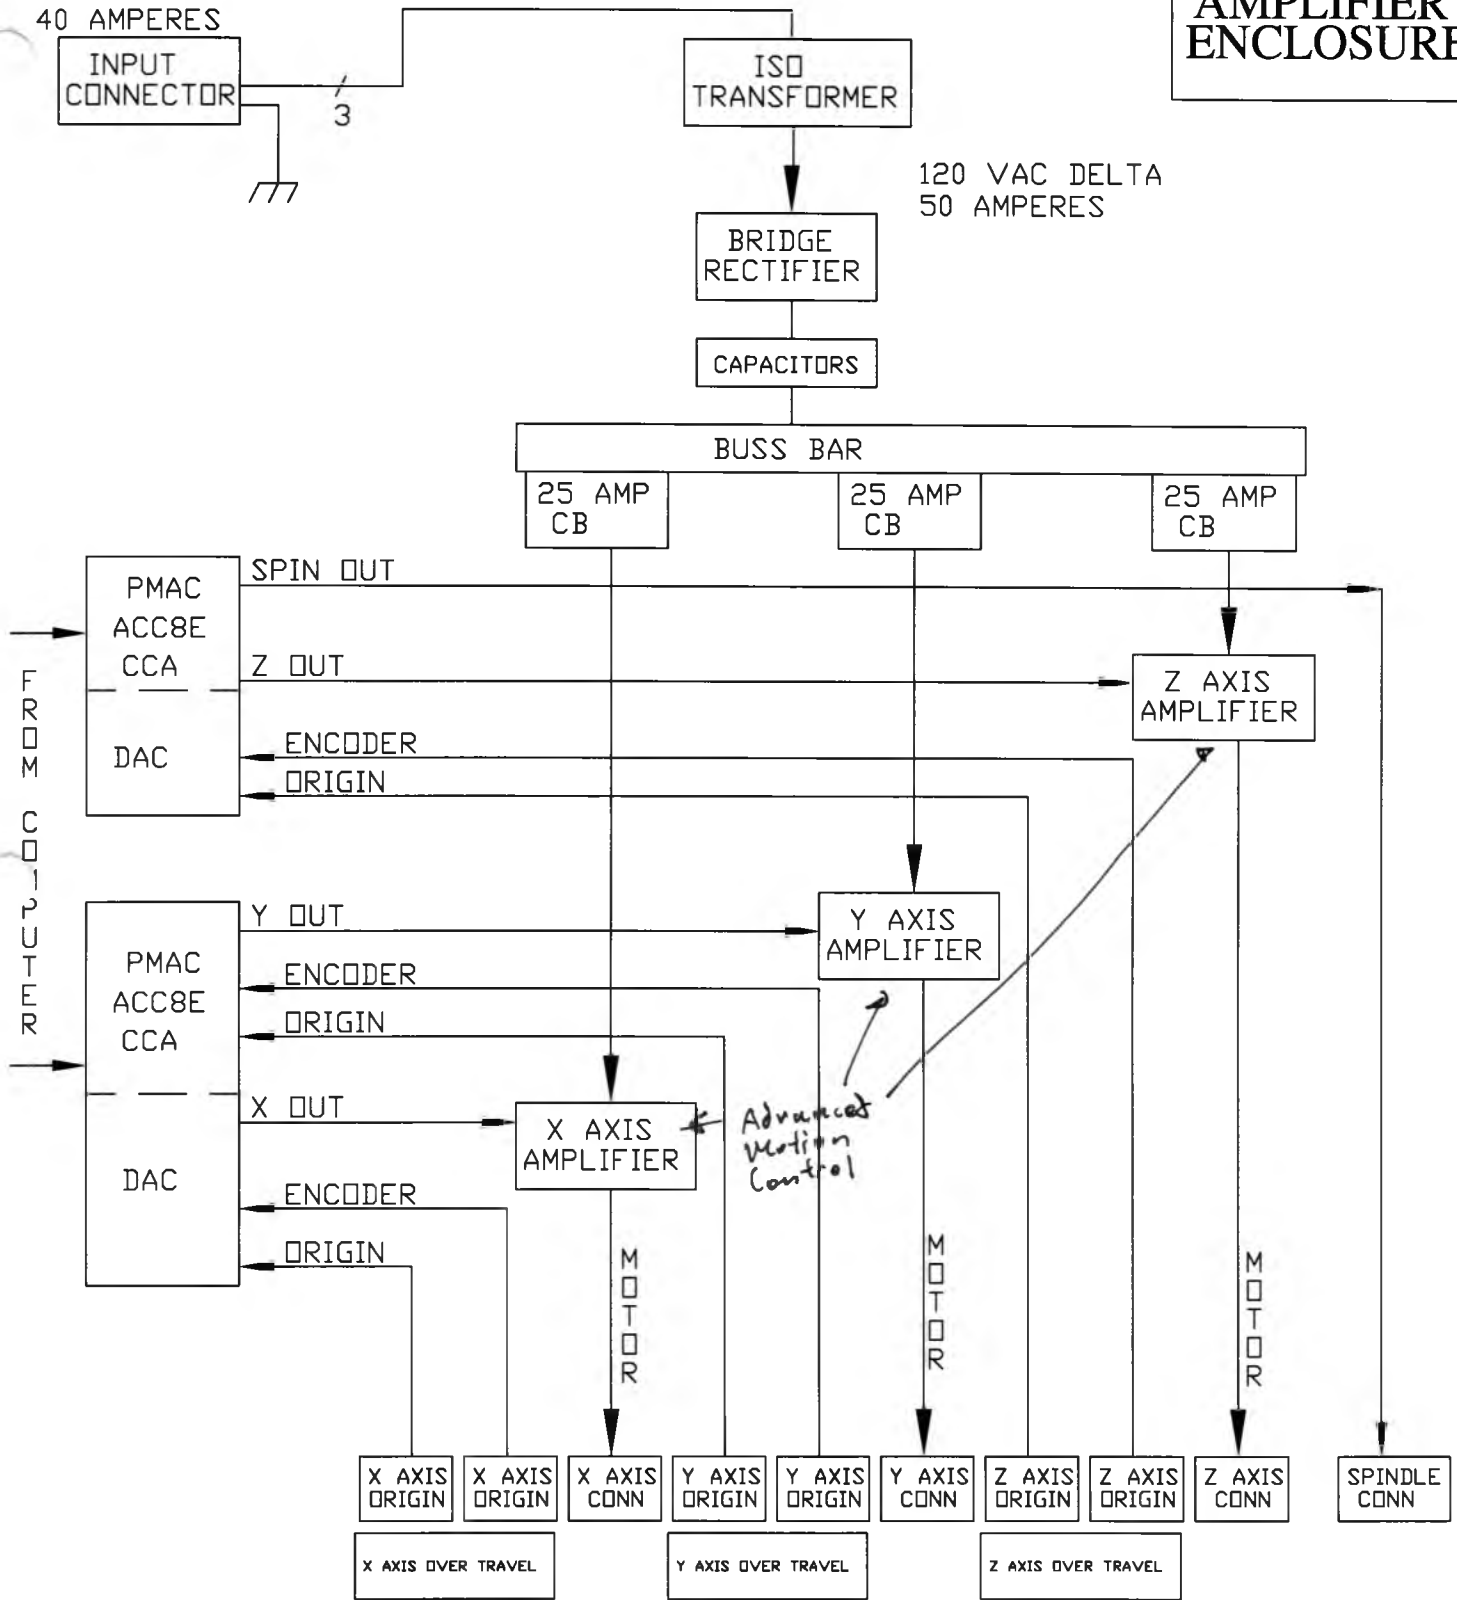

CCA MEANS CIRCUIT CARD ASSEMBLY
EMO MEANS EMERGENCY OFF
UV MEANS UNDERVOLTAGE TRIP
CB MEANS CIRCUIT BREAKER

DSGN | PAUL RAKO | 1/95
(408) 745-1094
FAX (408) 745-8073 FAX
PAGE: (408) 388-3242
THIS DRAWING CONTAINS
PROPRIETARY INFORMATION
AND IS NOT TO BE USED
OR REPRODUCED WITHOUT
THE PERMISSION OF
RAKO ELECTRONICS
COPYRIGHT © 1995
RAKO ELECTRONICS

RAKO ELECTRONICS
1181 Tamman Dr. Sunnyvale CA 94089
Box 61987, Sunnyvale CA 94088

BLOCK DIAGRAM,
MILLING MACHINE

SIZE	DRAWING NUMBER	REV
A	BLOCK	4

SCALE 1:1 FILE: BLOCK.DWG

SHEET 2 OF 8