SERVO AMPLIFIER ENCLOSURE

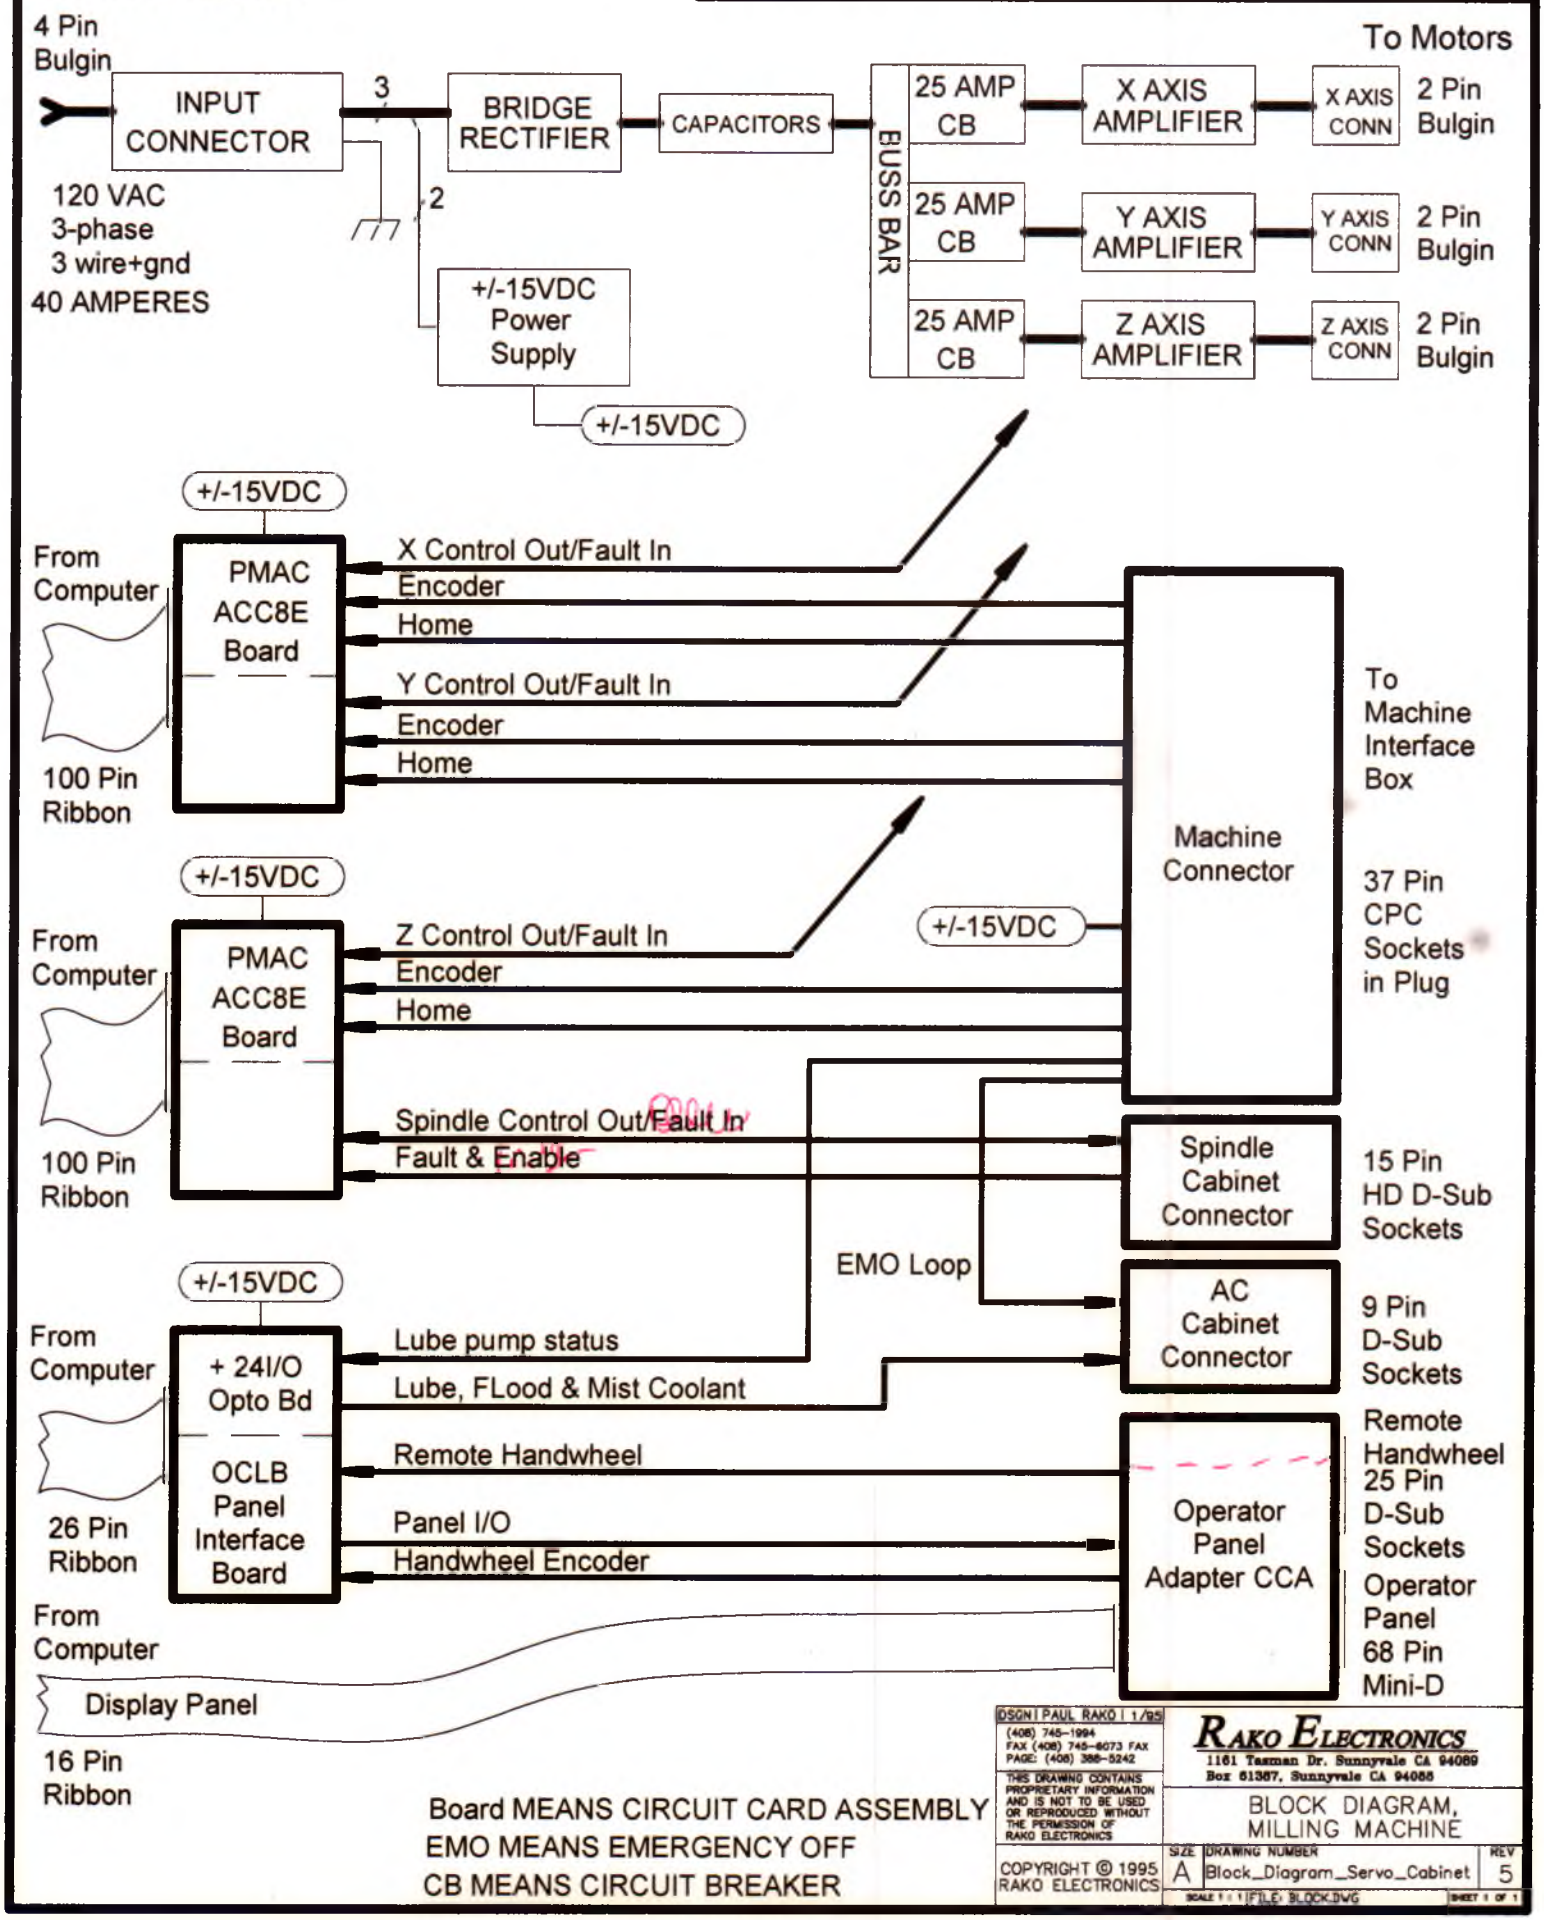

Board MEANS CIRCUIT CARD ASSEMBLY
EMO MEANS EMERGENCY OFF
CB MEANS CIRCUIT BREAKER

DSGN | PAUL RAKO | 1/95
(408) 745-1994
FAX (408) 745-6073 FAX
PAGE: (408) 388-5242

THIS DRAWING CONTAINS PROPRIETARY INFORMATION AND IS NOT TO BE USED OR REPRODUCED WITHOUT THE PERMISSION OF RAKO ELECTRONICS

COPYRIGHT © 1995 RAKO ELECTRONICS

RAKO ELECTRONICS
1161 Tasman Dr. Sunnyvale CA 94089
Box 61367, Sunnyvale CA 94088

BLOCK DIAGRAM, MILLING MACHINE

SIZE	DRAWING NUMBER	REV
A	Block_Diagram_Servo_Cabinet	5

SCALE 1 : 1 | FILE: BLOCK.DWG | SHEET 1 OF 1